



LOWER LEVEL: 313.3 SF

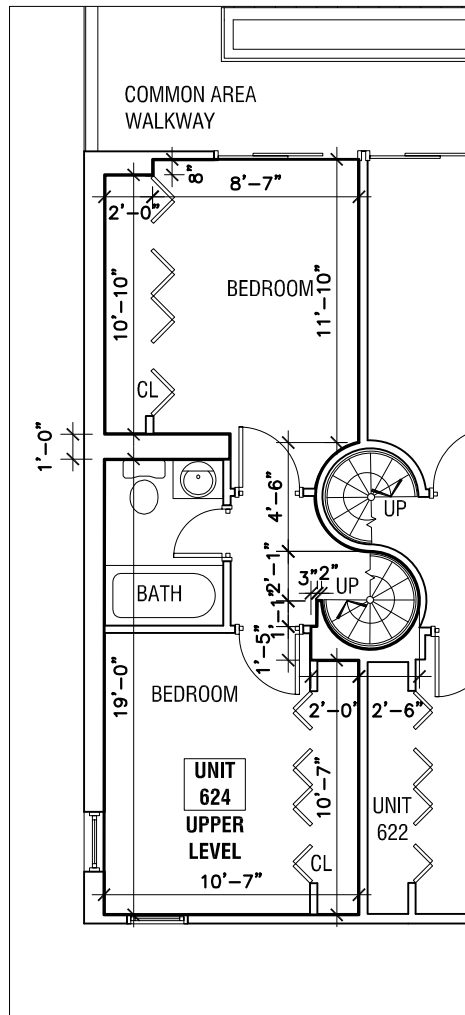

UPPER LEVEL: 327.4 SF


UNIT 624: 641 SF

SCALE: 1/8" = 1'-0"

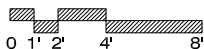

CERTIFICATION

I certify that this portion of the plans filed with the Master Deed of the XII Stoneholm Condominium shows the unit designation of the unit being conveyed and of immediately adjoining units, and that it fully and accurately depicts the layout of the unit, its location, dimensions, approximate area, main entrance and immediate common area to which it has access, as built. This plan was prepared in accordance with the rules and regulations of the Registry of Deeds of the Commonwealth of Massachusetts. The building has no name.

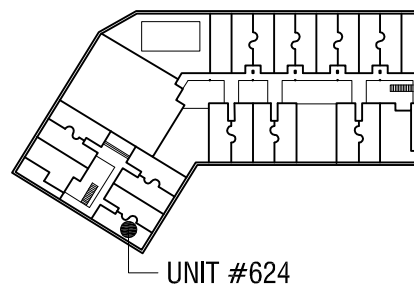

XII
STONEHOLM
CONDOMINIUM
12 Stoneholm Street
Boston, MA 02115



SCALE:
1/8"=1'-0"

DATE:
12.02.2005

DRAWING TITLE:

UNIT
624