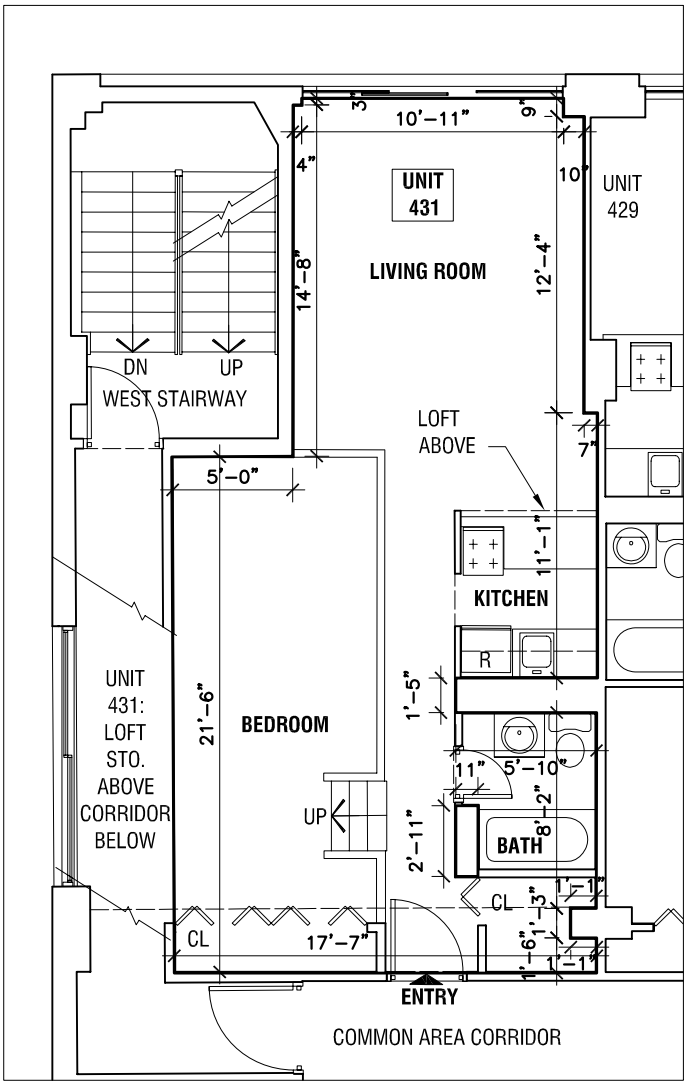

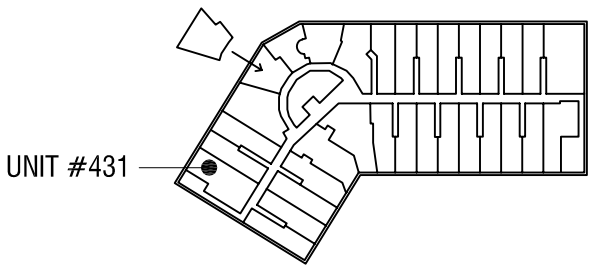

UNIT 431: 549 SF

SCALE: 1/8" = 1'-0"

0 1' 2' 4' 8'

CERTIFICATION

I certify that this portion of the plans filed with the Master Deed of the XII Stoneholm Condominium shows the unit designation of the unit being conveyed and of immediately adjoining units, and that it fully and accurately depicts the layout of the unit, its location, dimensions, approximate area, main entrance and immediate common area to which it has access, as built. This plan was prepared in accordance with the rules and regulations of the Registry of Deeds of the Commonwealth of Massachusetts. The building has no name.

Julie Sullivan Jones — Date
MA Registered Architect #6653

SullivanJones Studio
224 Marlborough Street No. 22
Boston, Massachusetts 02116
O: 617.424.7180
F: 617.424.7150
www.SullivanJonesStudio.com
© Sullivan Jones Studio

XII STONEHOLM CONDOMINIUM
12 Stoneholm Street
Boston, MA 02115

DRAFT

SCALE: **1/8"=1'-0"**

DATE: **12.02.2005**

DRAWING TITLE:

UNIT 431